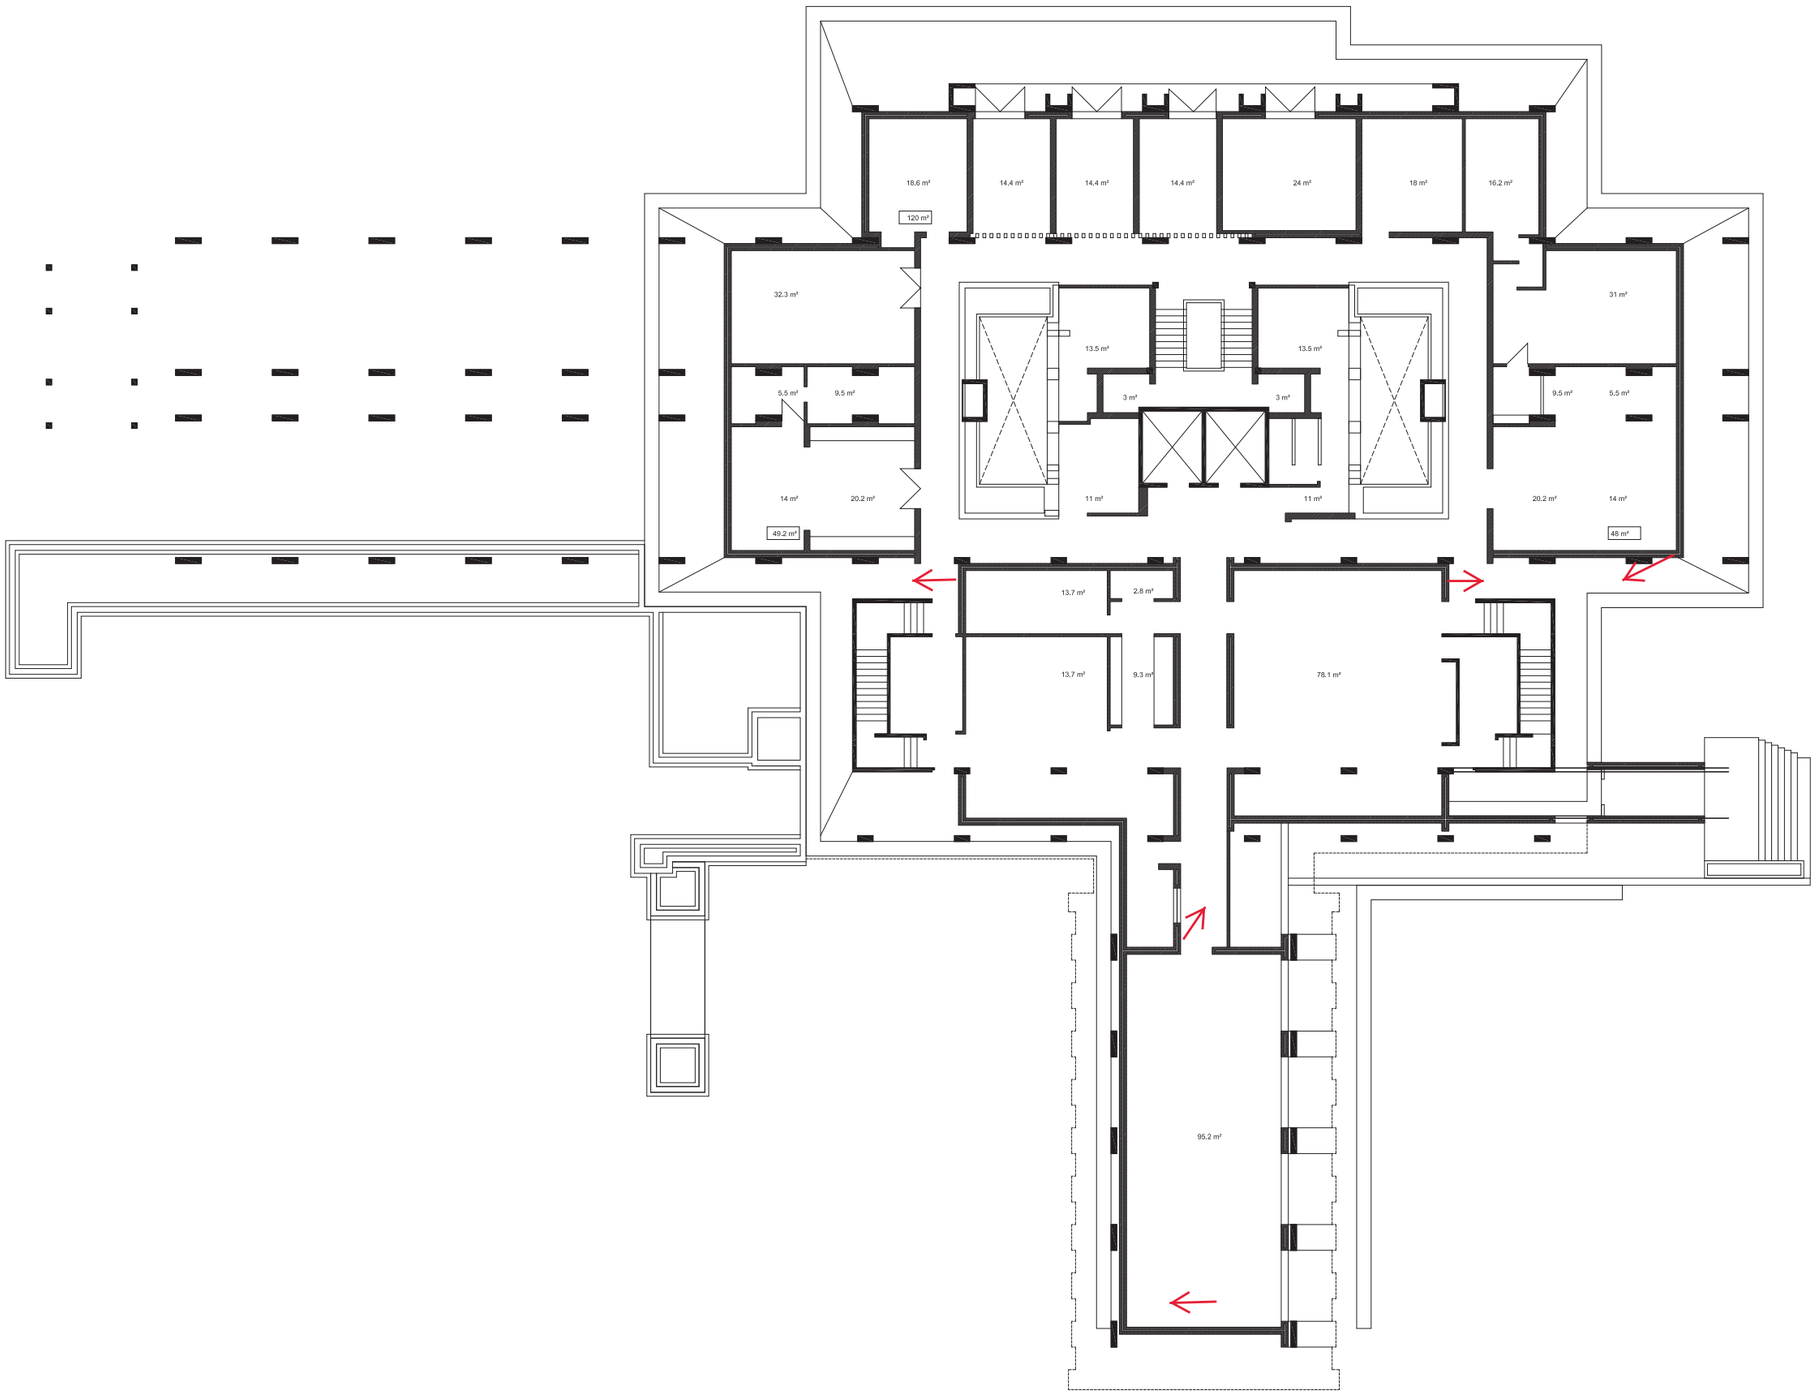


E


BOOK STORE

E

PHASE 1(RED)
5MP = 1
2MP = 4

HERBERIUM
BASEMENT
CCTV


BASEMENT FLOOR

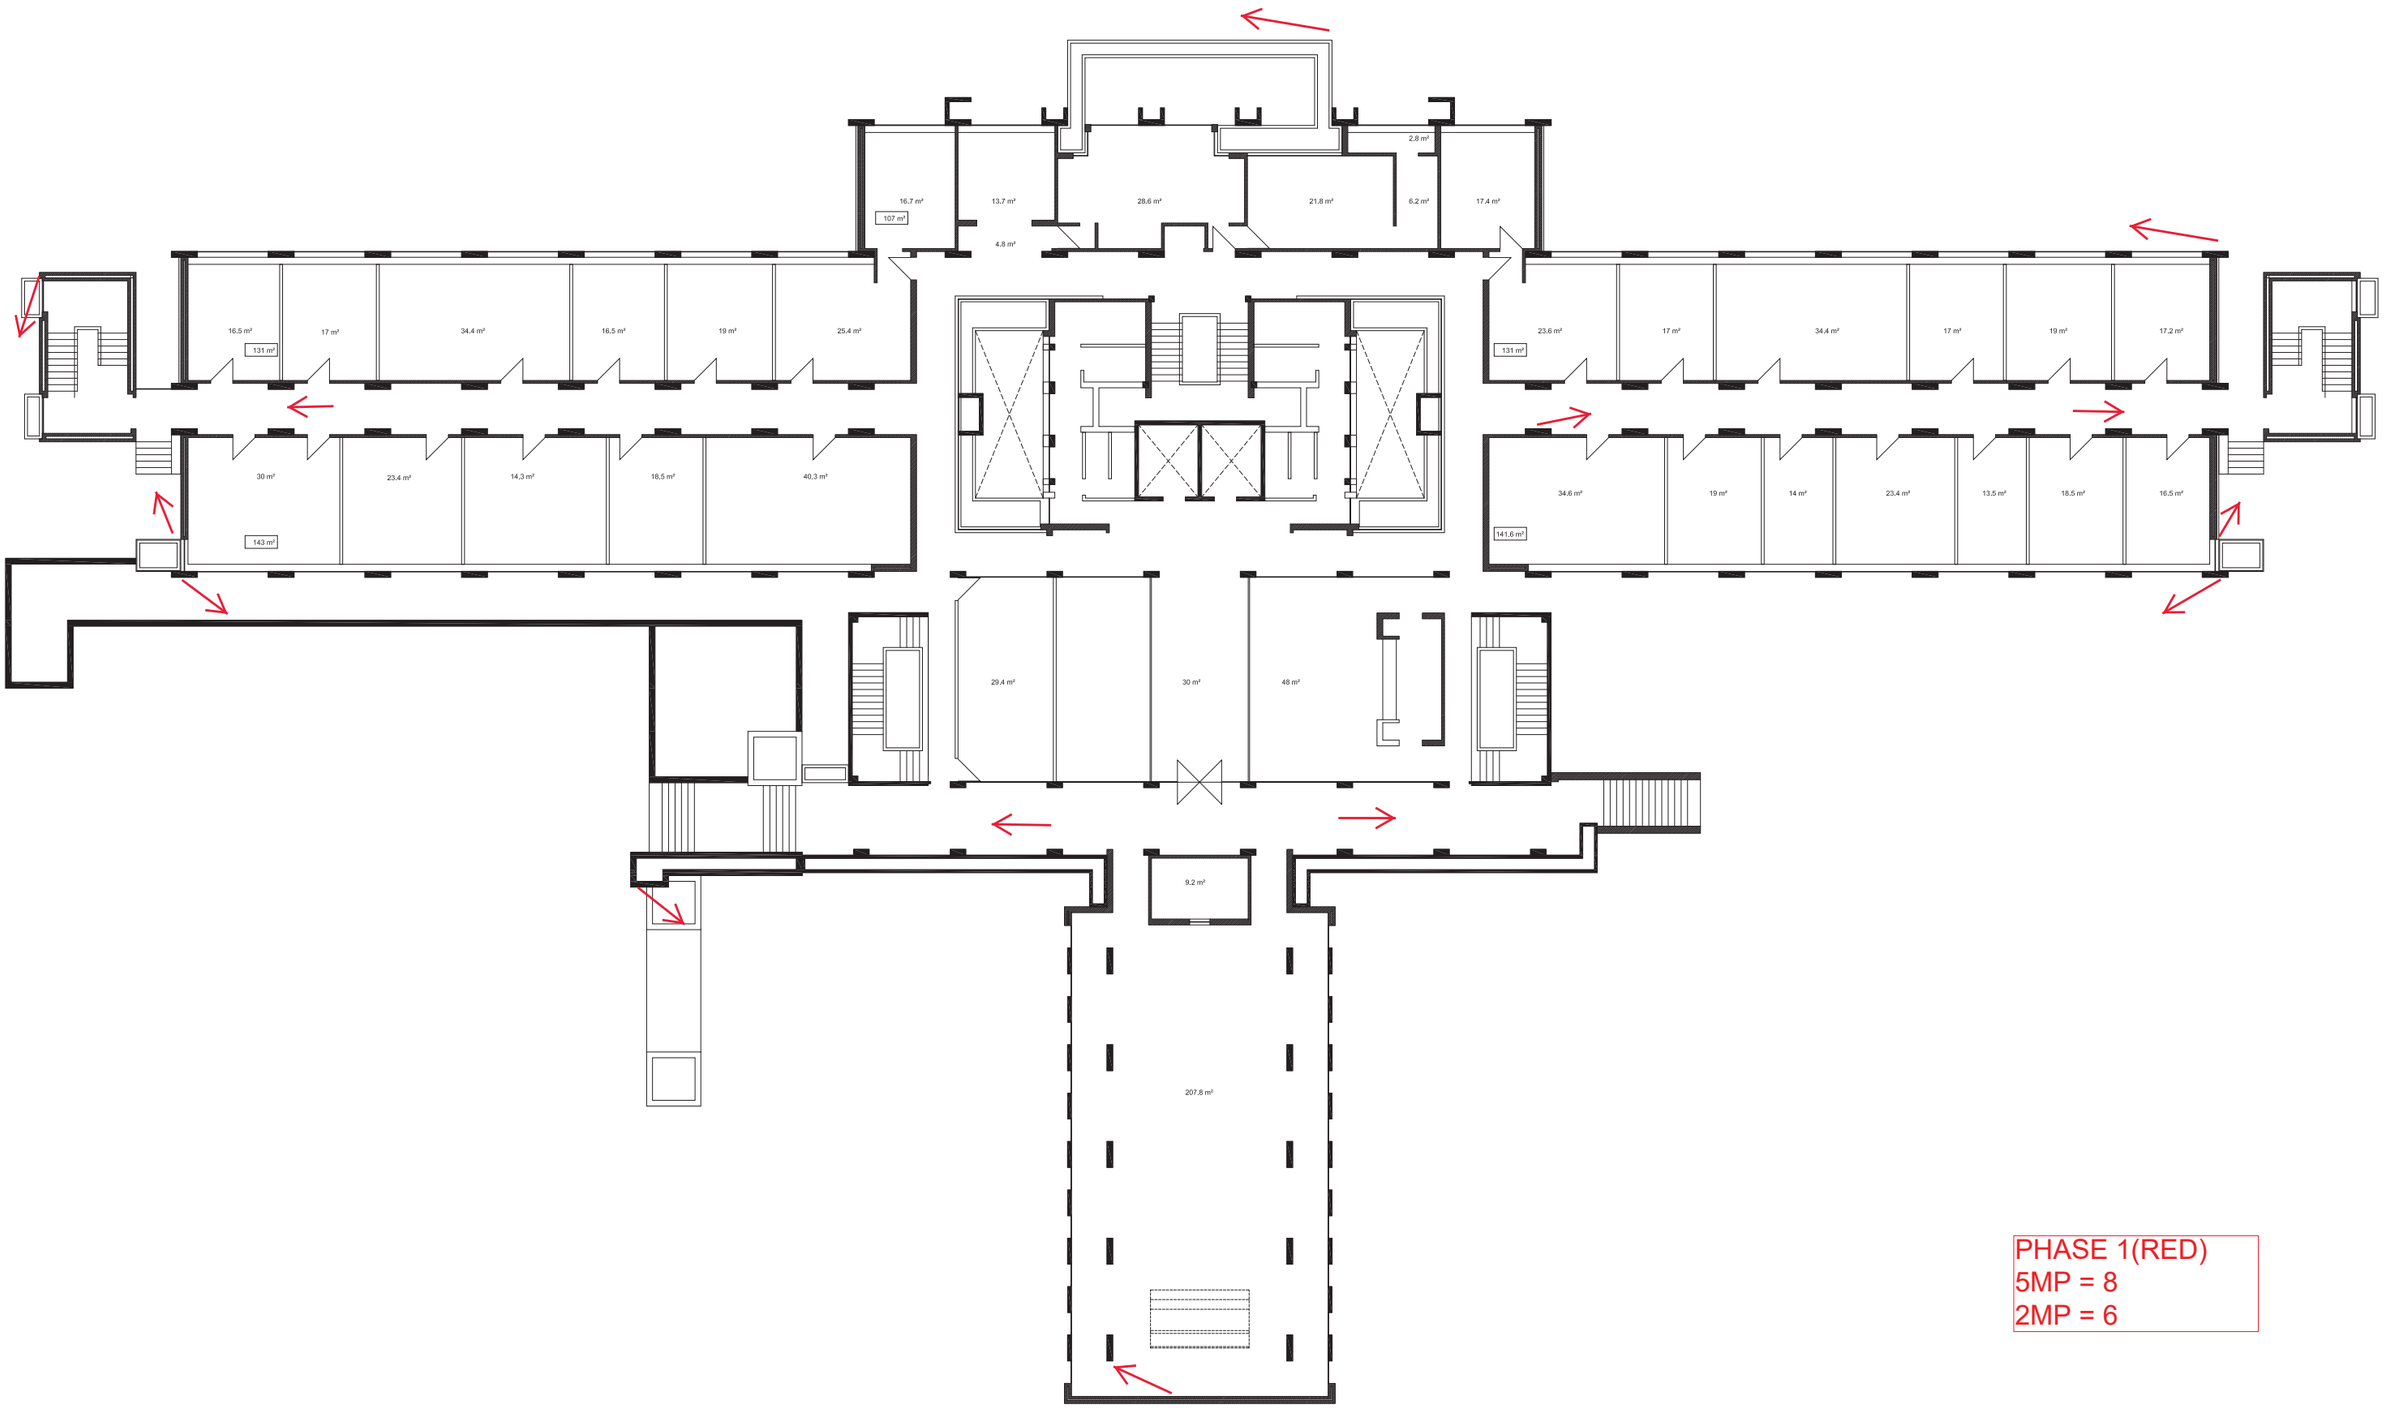

PHASE 1(RED)
5MP = 8
2MP = 6

HERBERIUM
GROUND FLOOR
CCTV


GROUND FLOOR PLAN

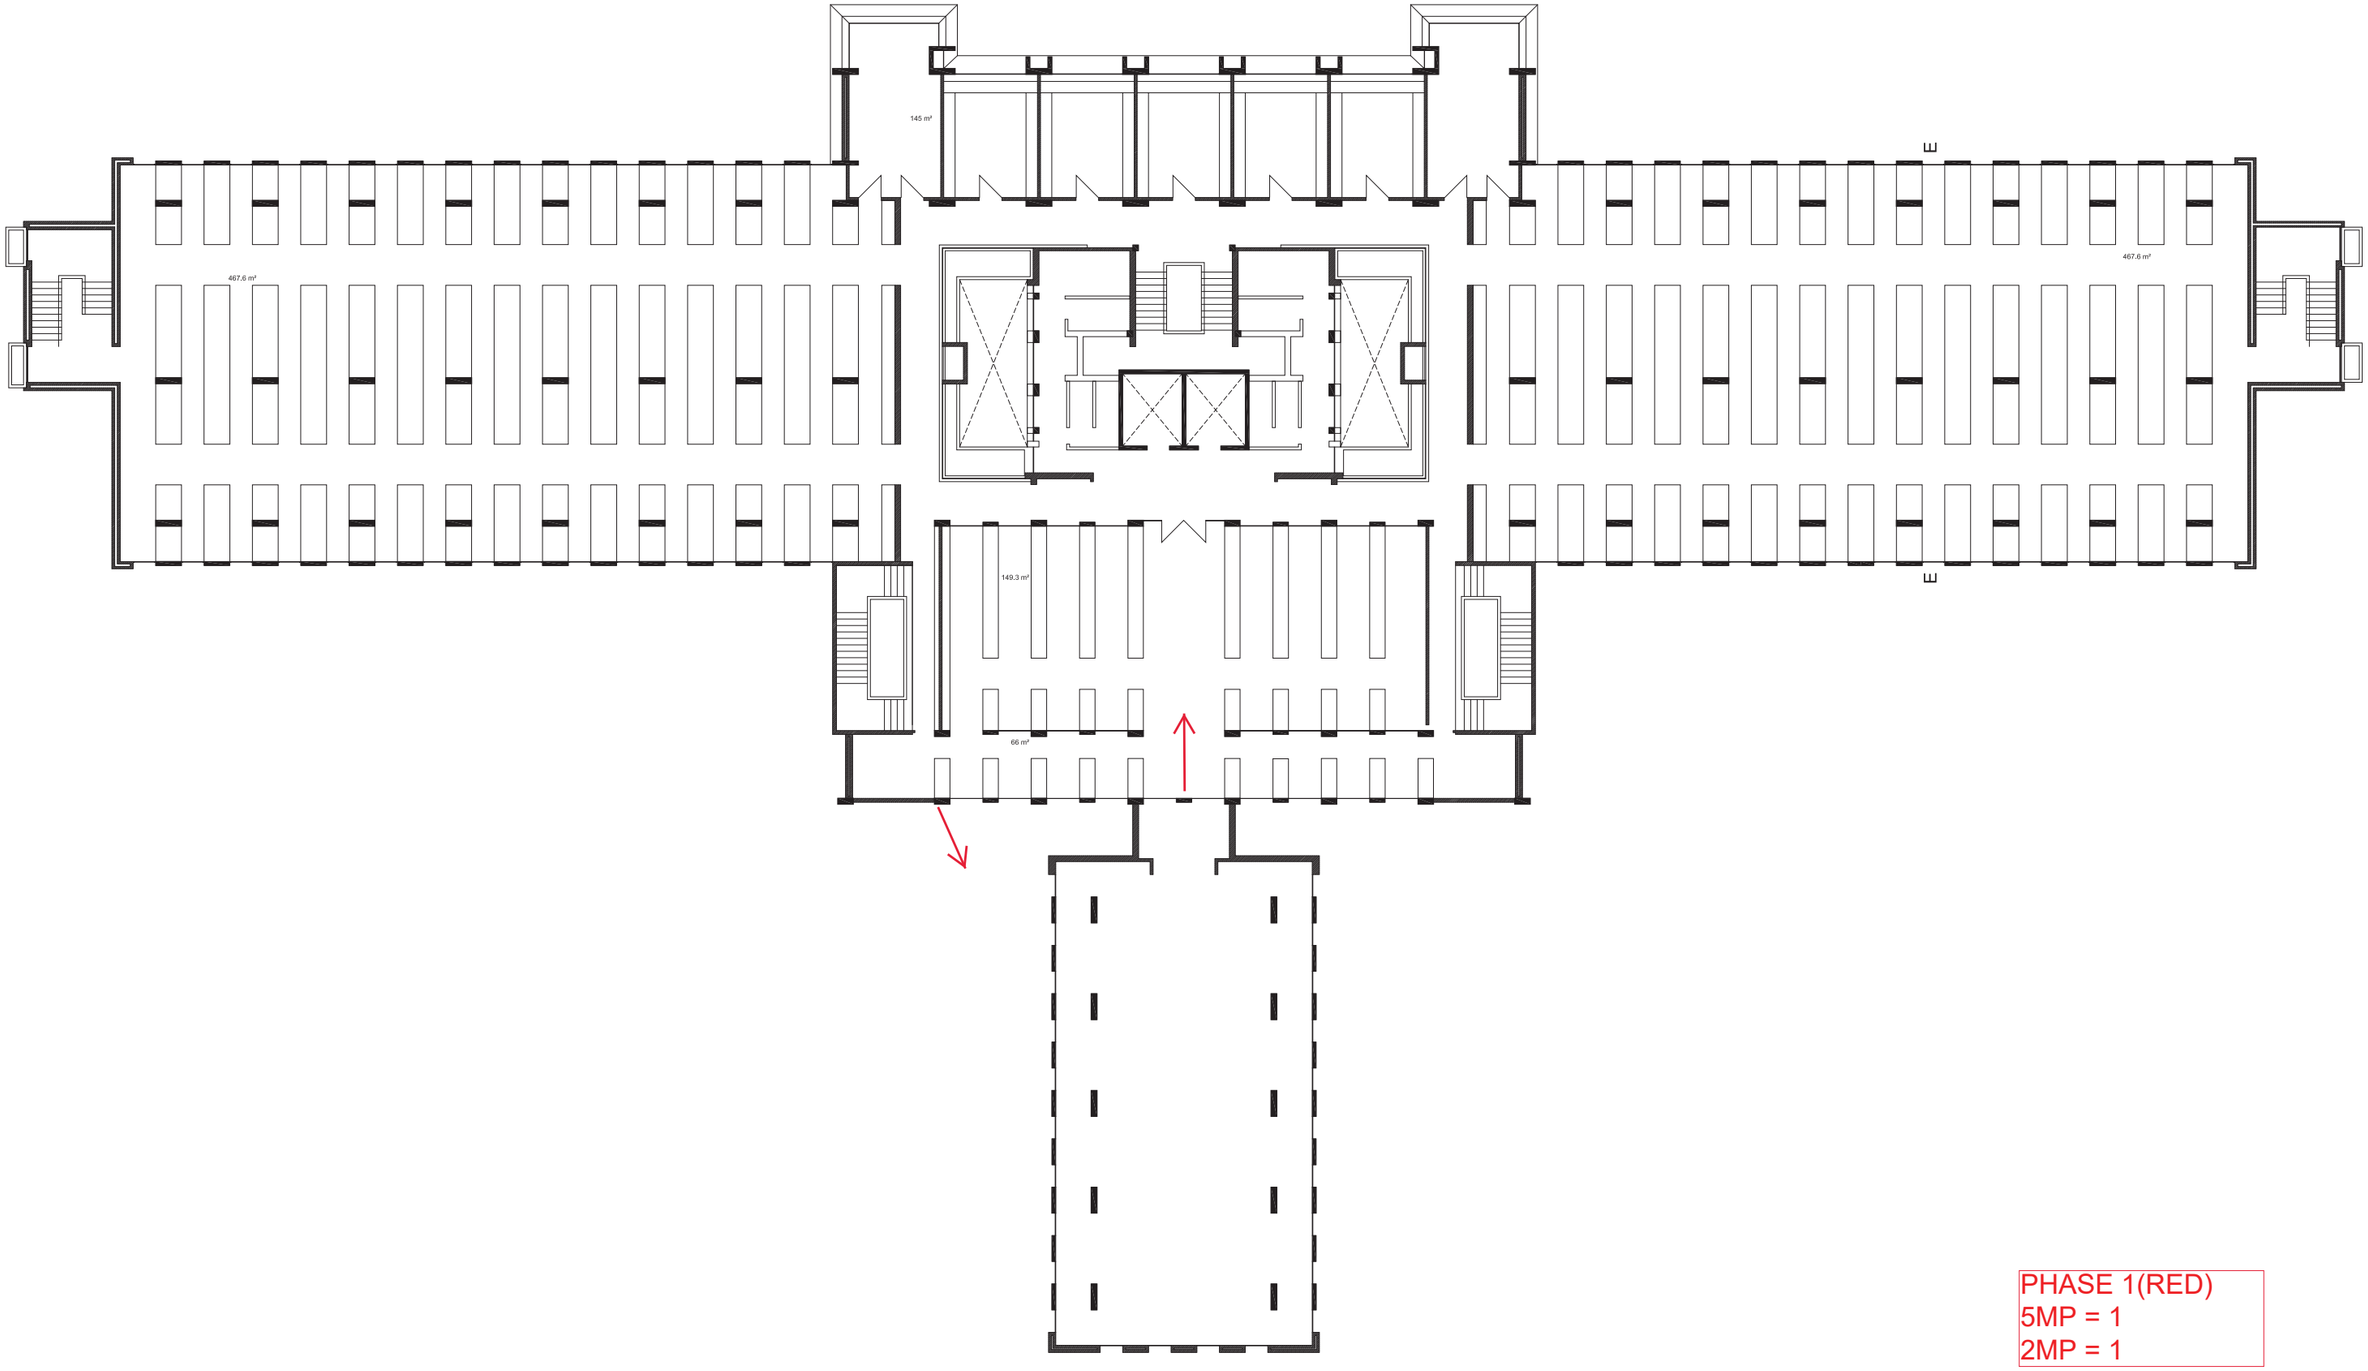

PHASE 1(RED)
5MP = 1
2MP = 1

HERBERIUM
FIRST FLOOR
CCTV

FIRST FLOOR PLAN

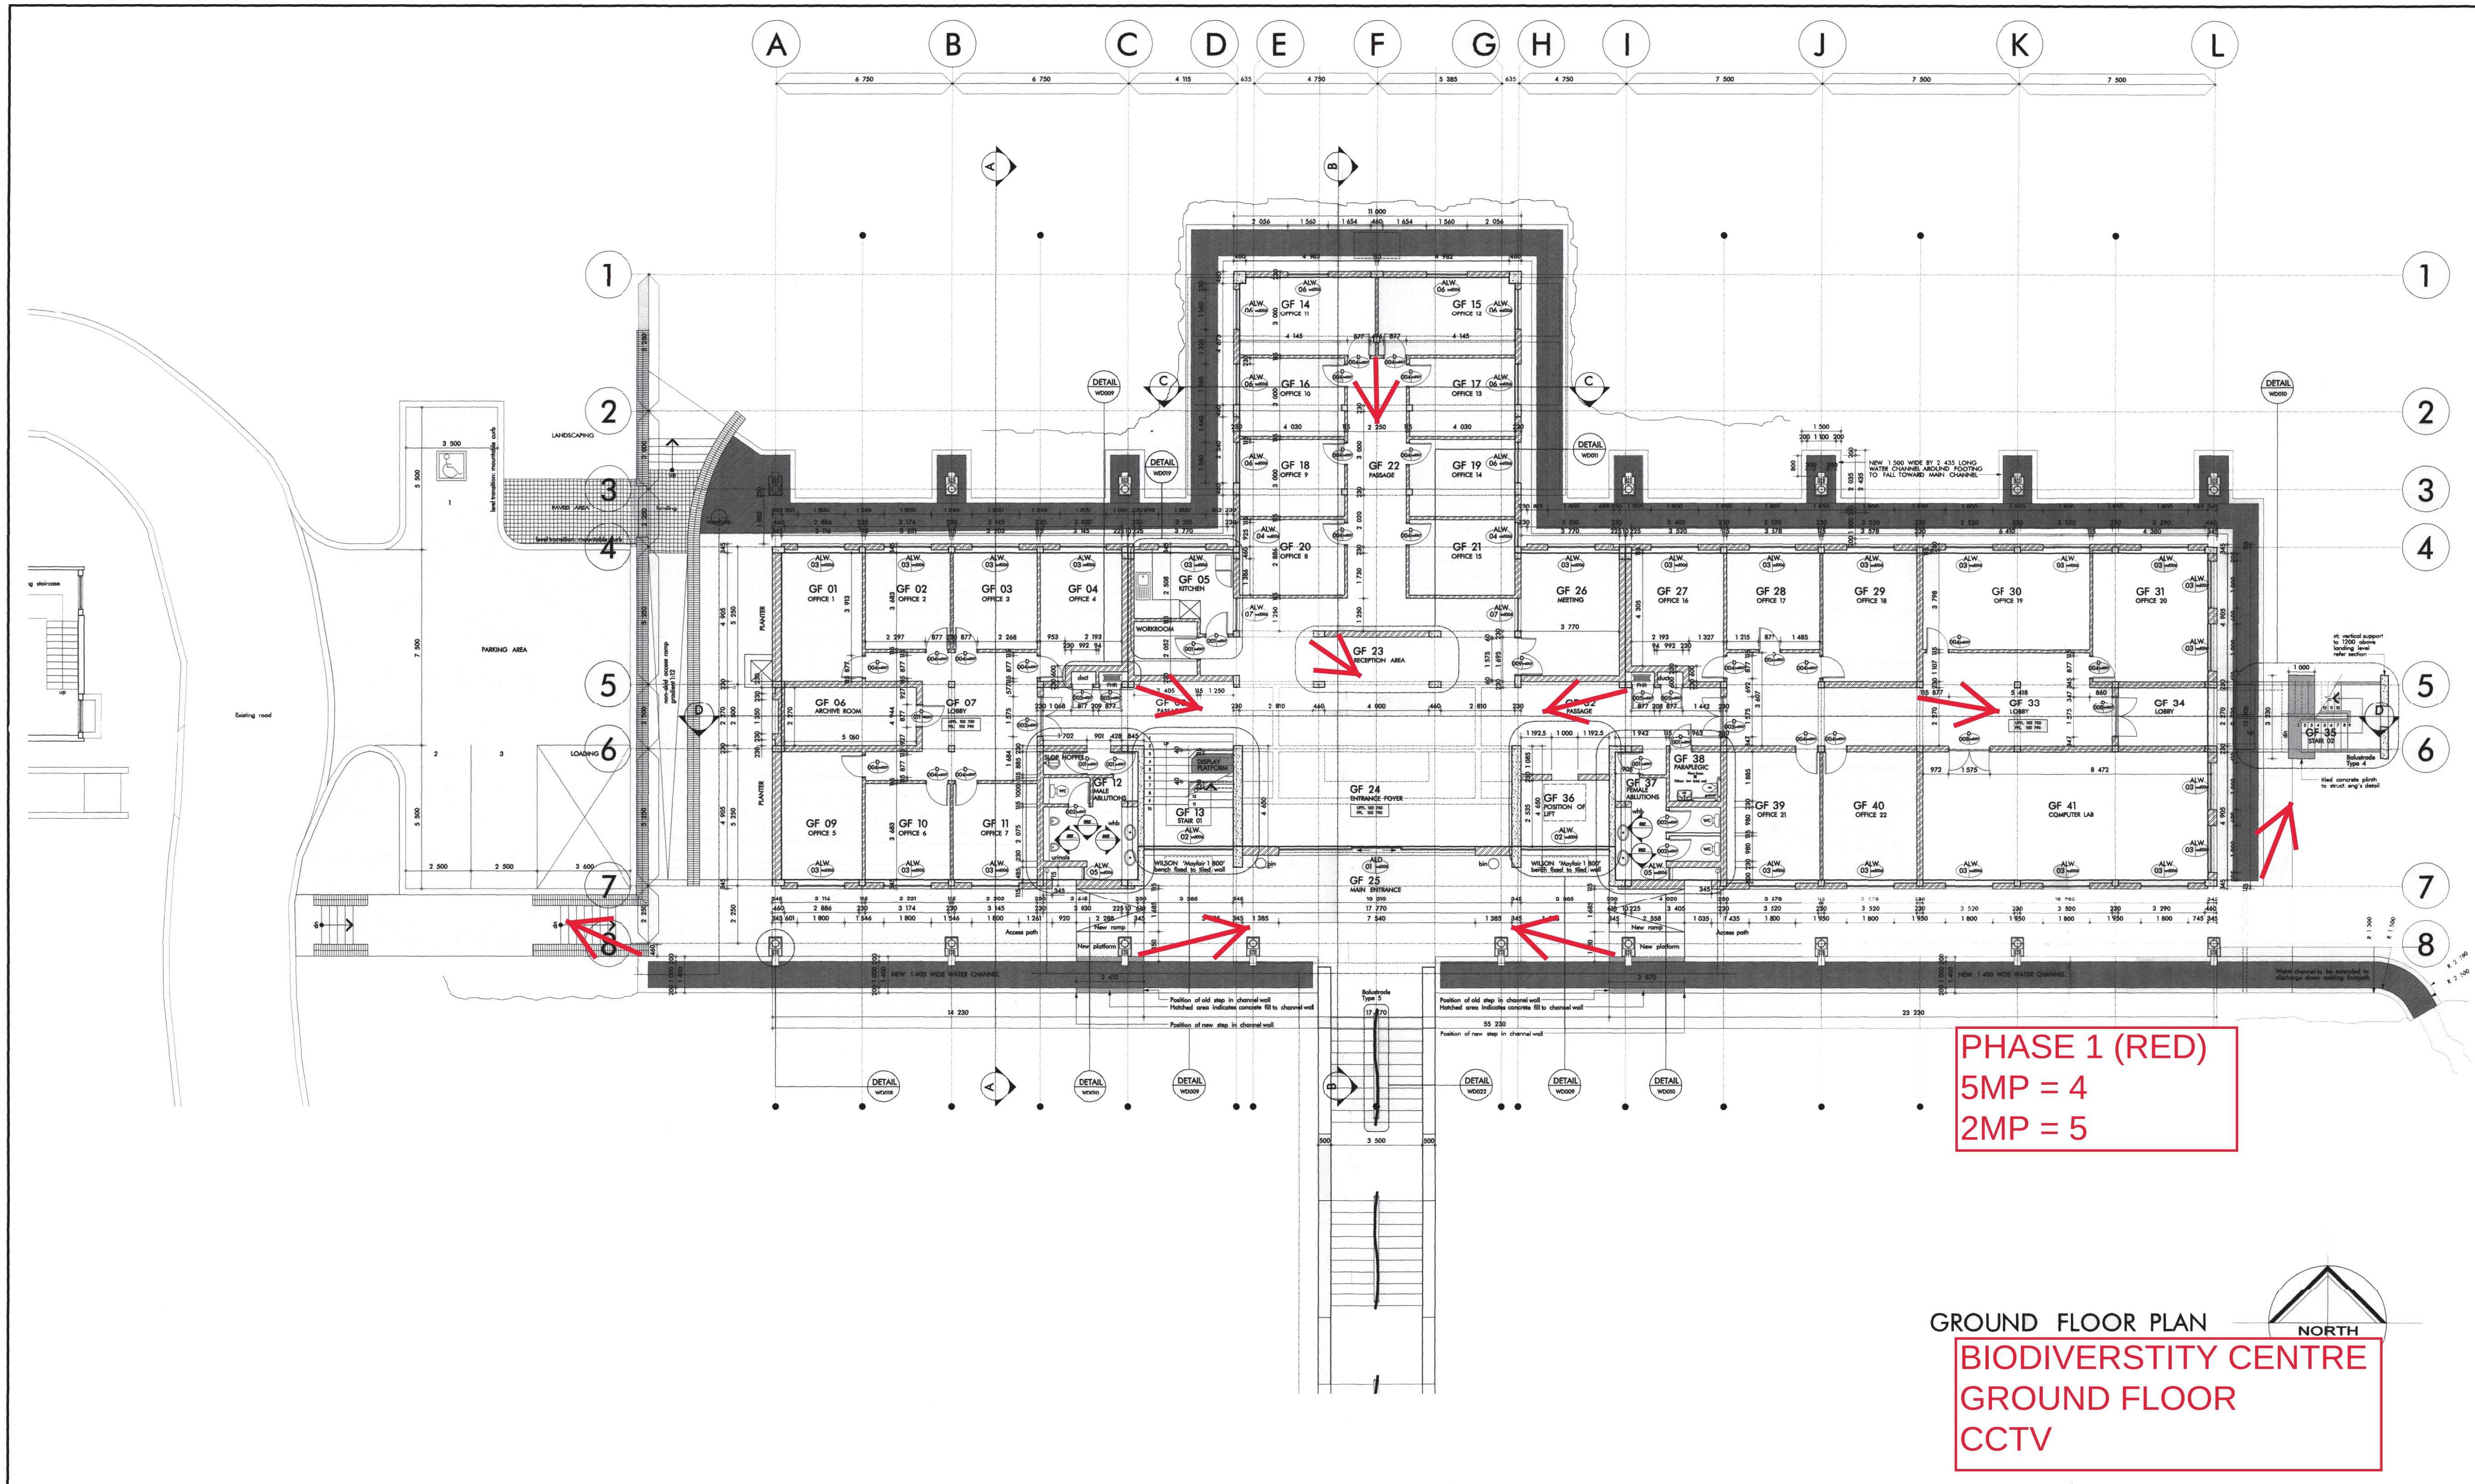

PHASE 1 (RED)
5MP = 4
2MP = 5

BIODIVERSTITY CENTRE
GROUND FLOOR
CCTV

REFERENCE FILES ATTACHED	LEVELS OFF
i:\cad\bn005-nbi\mainbldg\dgn\plan_c\fp1.dgn	none
i:\cad\bn005-nbi\mainbldg\dgn\plan_c\struct_gf.dgn	none
i:\cad\bn005-nbi\mainbldg\dgn\plan_c\grid_fp.dgn	none

R	DATE	INIT	DESCRIPTION
8	05 07 2004	VM	UPDATED RAMP & WALKWAY @ WEST PARKING AREA, & BALUSTRADE @ STAIR 03
9	03 08 2004	VM	REMOVED ALW 10 @ ARCHIVE ROOM
10	13 08 2004	VM	UPDATED POSITION OF CONCRETE CHANNEL ACCORDING TO AS BUILT, ADDED DISPLAY PLATFORM UNDER STAIR 01, UPDATED ALD 01, ADDED RAMPS TO WALKWAY ADJACENT TO MAIN ENTRANCE TO COMPENSATE FOR LEVEL DIFFERENCE & EXTENDED CHANNEL TO DISCHARGE DOWN FOOTPATH, WHERE NEW RUNOFF CHANNEL IS TO OCCUR TO FUTURE DETAIL

NATIONAL BOTANICAL INSTITUTE

BILDNAGAR
P O BOX 95664 WATERKLOOF 0145
TEL : (012) 460 7053 FAX : (012) 460 4131
e - mail : architects@bild.co.za
PRETORIA

NATIONAL BOTANICAL INSTITUTE

PROPOSED BIO-DIVERSITY CENTRE, PRETORIA

GROUND FLOOR PLAN

DRAWN:	DATE:	SCALE:	PROJECT NO:
VIRESH	14 08 2003	1:100	BN005


DWG. NO:	REV
WD 002	10

J. M. Gouws B. Arch. SACA 2704 SAIA 3363

©BILD Architects 2002

FOR OFFICE USE ONLY	
REFERENCE FILES ATTACHED	LEVELS OFF
i:\cad\bn005-nbi\mainbldg\dgn\plan_c\fp2.dgn	none
i:\cad\bn005-nbi\mainbldg\dgn\plan_c\struct_ff.dgn	none
i:\cad\bn005-nbi\mainbldg\dgn\plan_c\grid_fp.dgn	none

NOTES

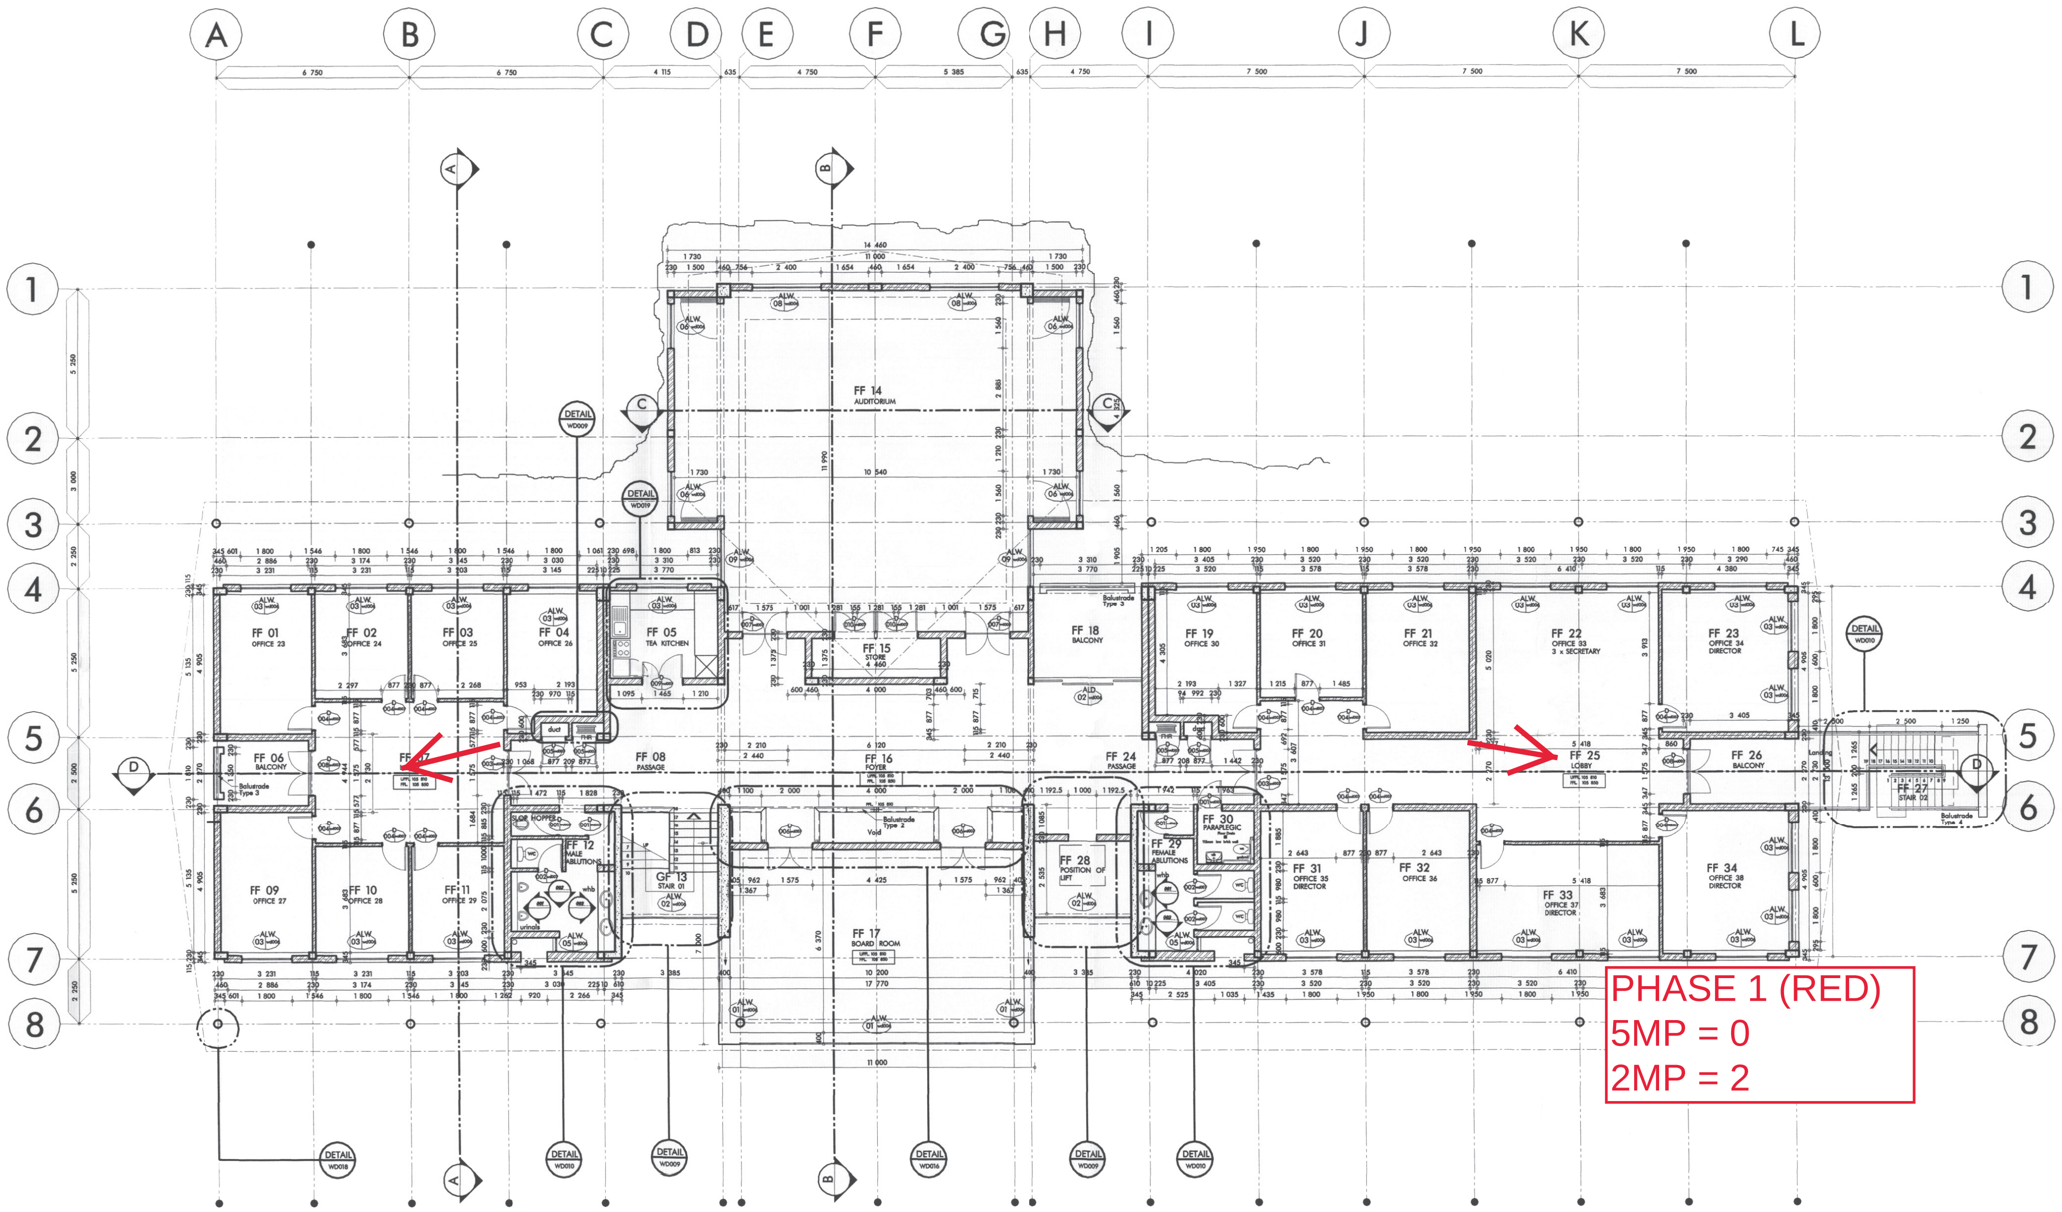

PHASE 1 (RED)
5MP = 0
2MP = 2

FIRST FLOOR PLAN

BIODIVERSTITY CENTRE
FIRST FLOOR
CCTV

NORTH

REVISIONS

R	DATE	INIT	DESCRIPTION
0	14 08 2003	VM	ISSUED FOR CONCTRUCTION
1	21 11 2003	LW	ADDED OUTSTANDING DIMENSIONS TO TOILETS
2	05 12 2003	VM	CO-ORDINATED WITH STRUCT. ENG. DRAWINGS
3	20 01 2004	VM	NEW WINDOWS ADDED TO AUDITORIUM
			NEW COLUMNS ADDED AS PER STRUCT. ENG.
			ENLARGENED ALW 03 TO CLIENT'S REQUEST
			ADDED NEW DOOR (D9)
4	09 02 2004	VM	REVISED WIDTH OF EAST WALL
			INDICATED SLIDING SECTIONS FOR ALW 01
5	21 05 2004	VM	ADDED BRICK LINTEL TO ENTRANCE OF ABLUTIONS

NATIONAL BOTANICAL INSTITUTE

BILDNAGAR
BILDNAGAR ARCHITECTS (PTY) LTD REG. NR. 2000/026605/07
P O BOX 95664 WATERKLOOF 0145
TEL : (012) 460 7053 FAX : (012) 460 4131
e - mail : architects@bild.co.za
PRETORIA

CLIENT
NATIONAL BOTANICAL INSTITUTE

PROJECT
PROPOSED BIO-DIVERSITY CENTRE, PRETORIA

TITLE
FIRST FLOOR PLAN

DRAWN:	DATE:	SCALE:	PROJECT NO:
VIRESH	~~14 08 2003~~ 21/5/04	1:100	BN005
DWG. NO: WD 003			REV: 5
J. M. Gouws B. Arch. SACA 2704 SAIA 3863			

© BILD Architects 2002